





DECK FRAMING
1/4"=1'

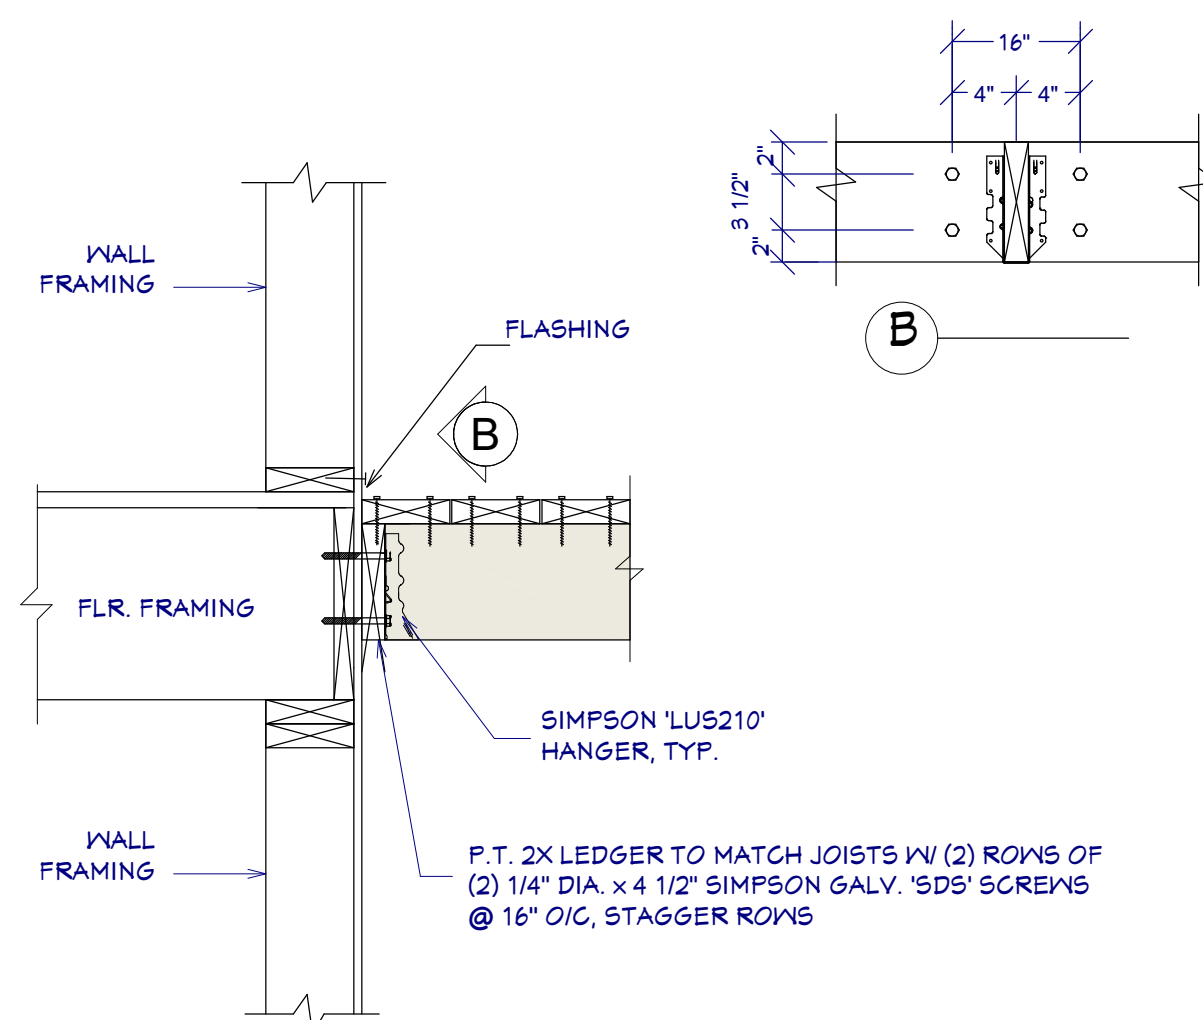

A LEDGER CONNECTION
SCALE 1"=1'

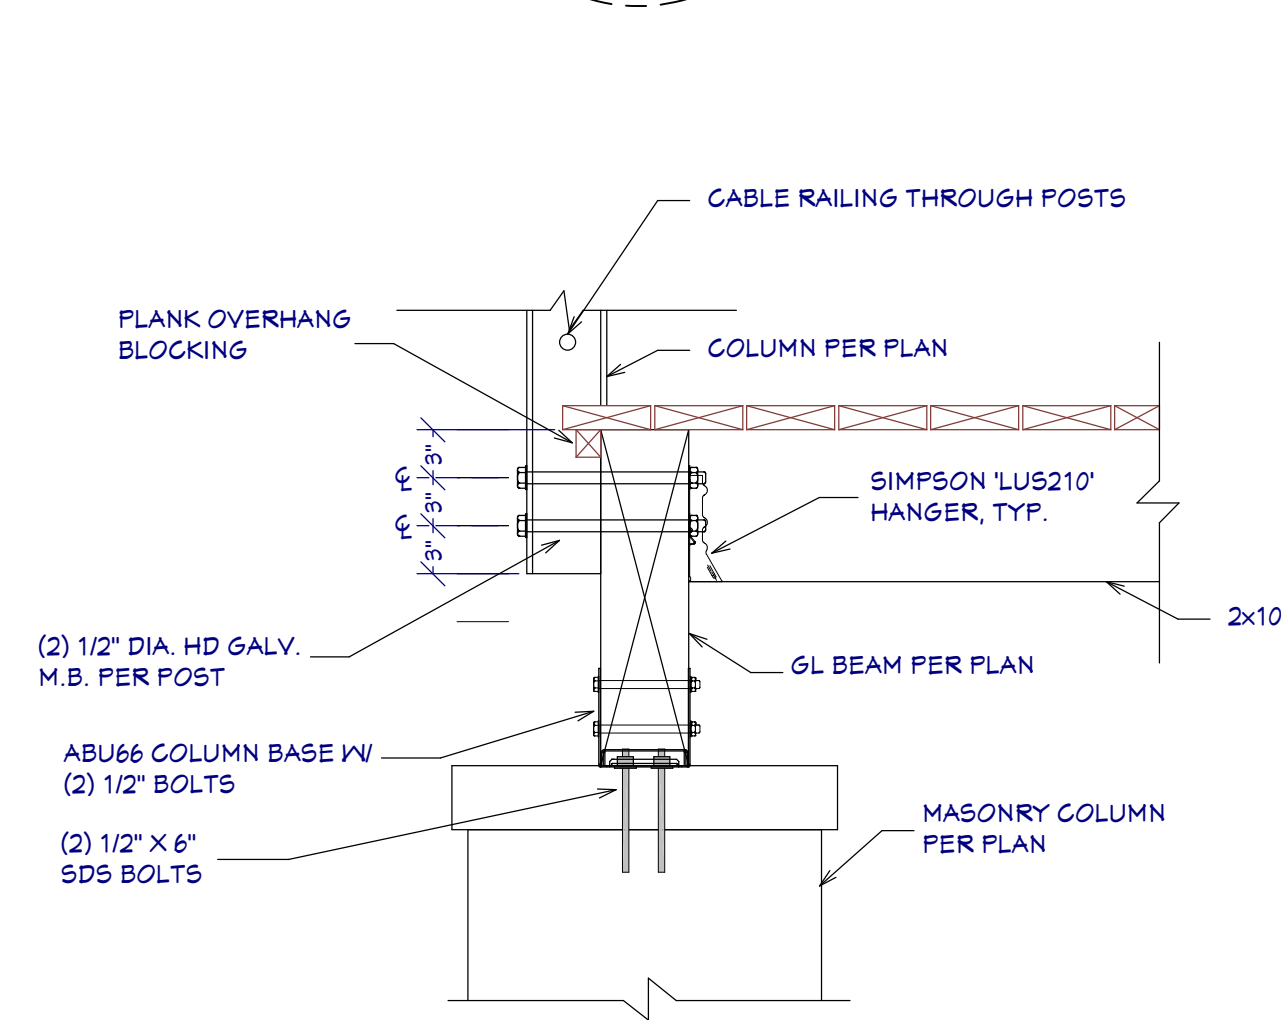

C BEAM POST CONNECTION
SCALE 1"=1'

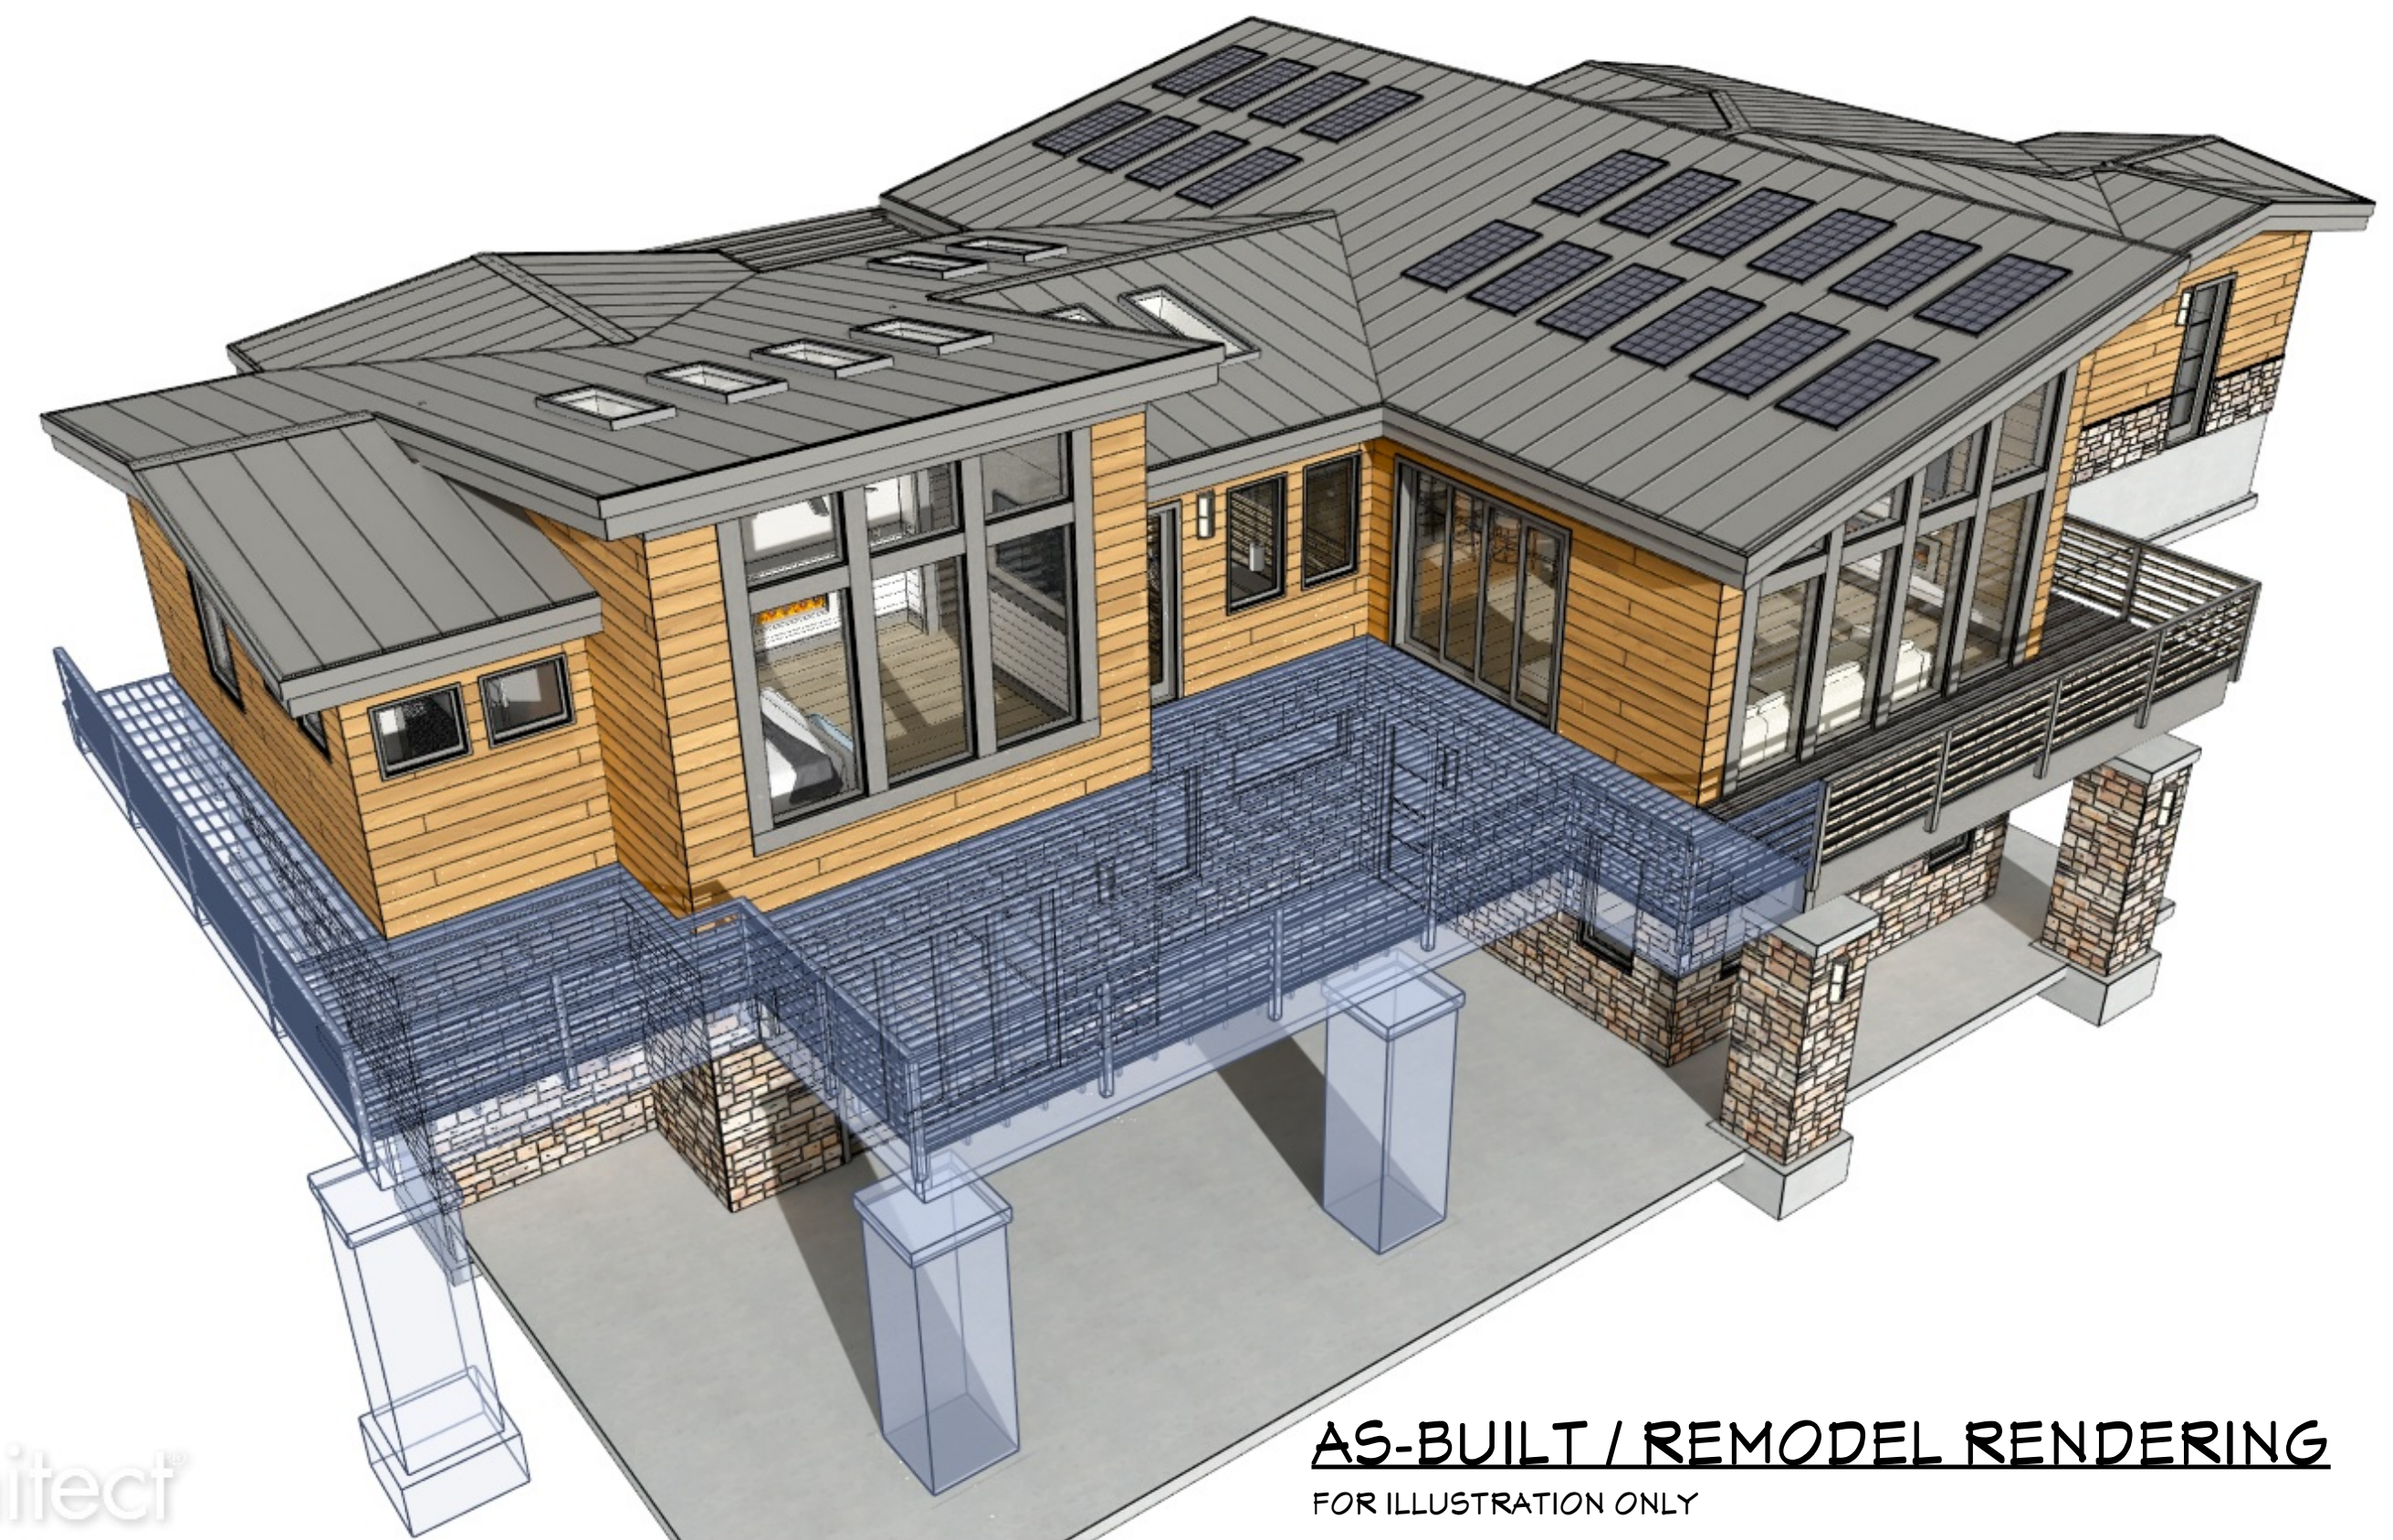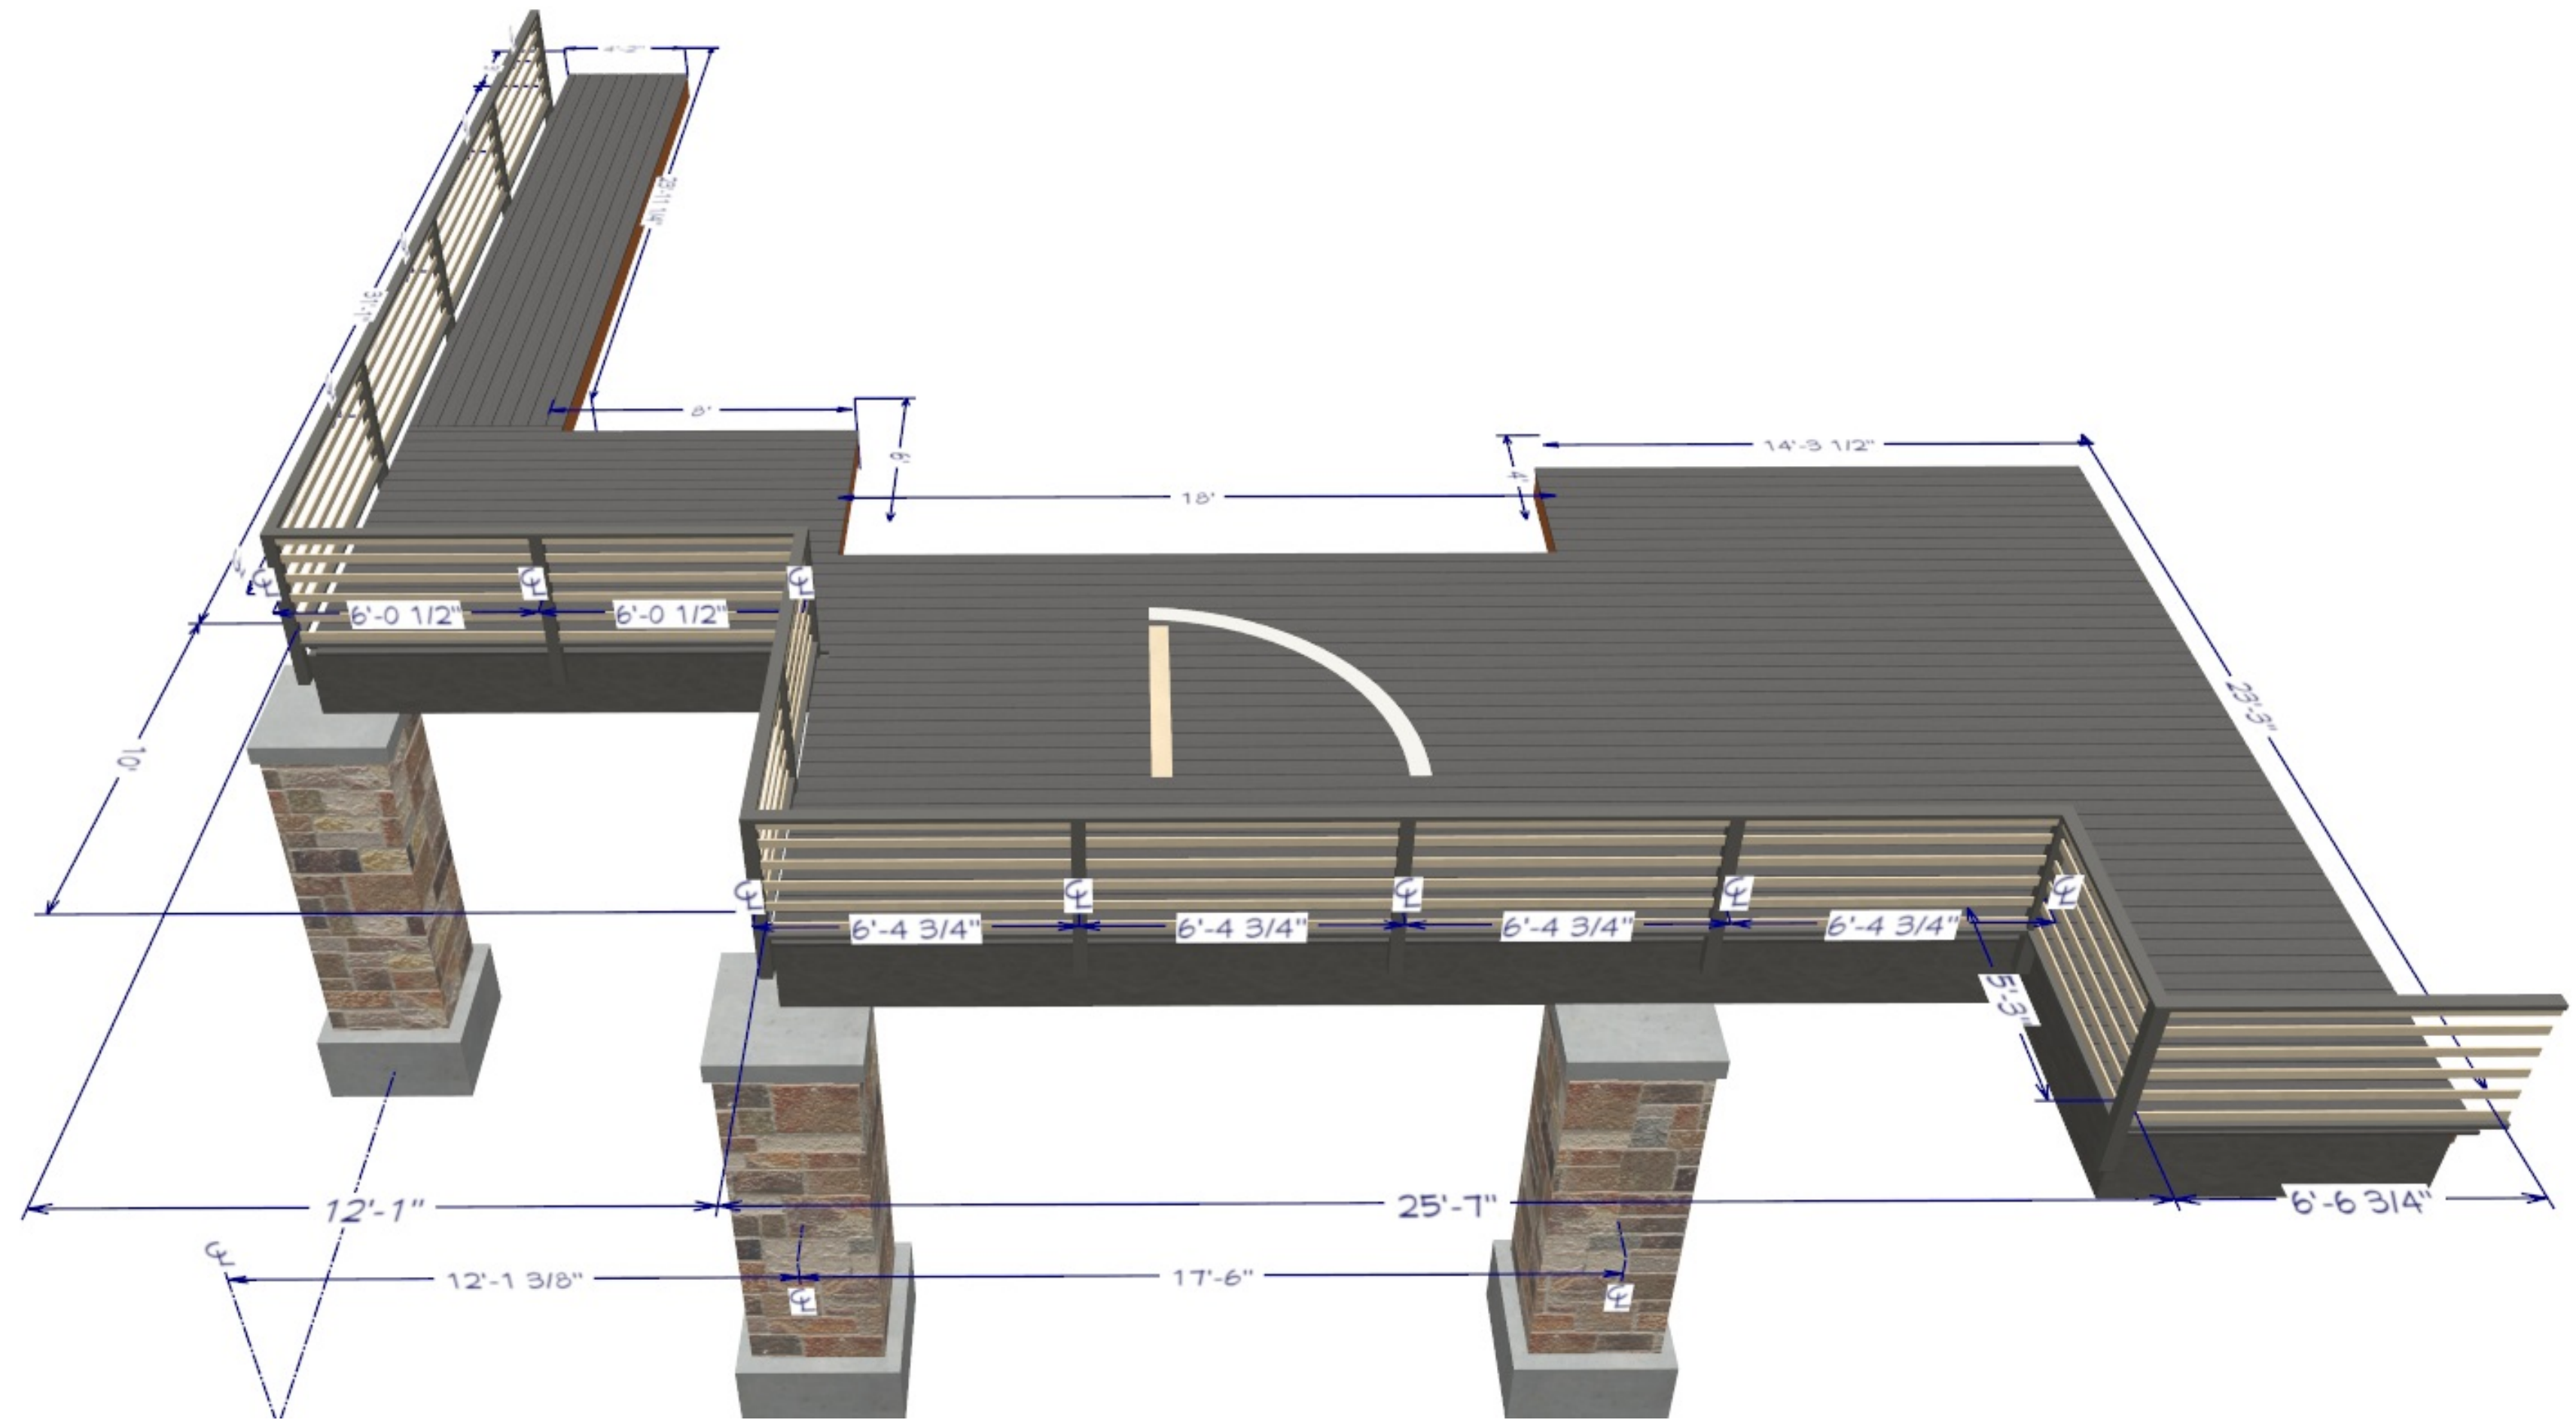

AS-BUILT / REMODEL RENDERING
FOR ILLUSTRATION ONLY

SHEET NUMBER

1

SCALE @ 24" X 36"

DATE: REV. —

DRAWN BY: S.H.

**BACHELOR VIEW
DECK REMODEL**

COEUR D'ALENE, IDAHO

DECK REMODEL

© 2024

Chief Architect
6500 N. Mineral Dr. Coeur d'Alene, ID. 83815
208.292.3400
chiefarchitect.com